
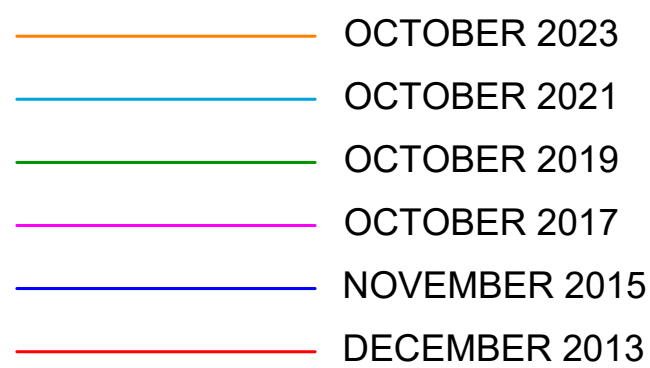
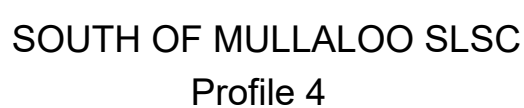
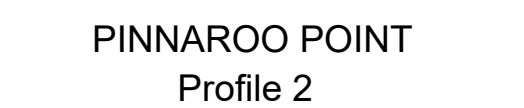


Appendix B Profile Surveys

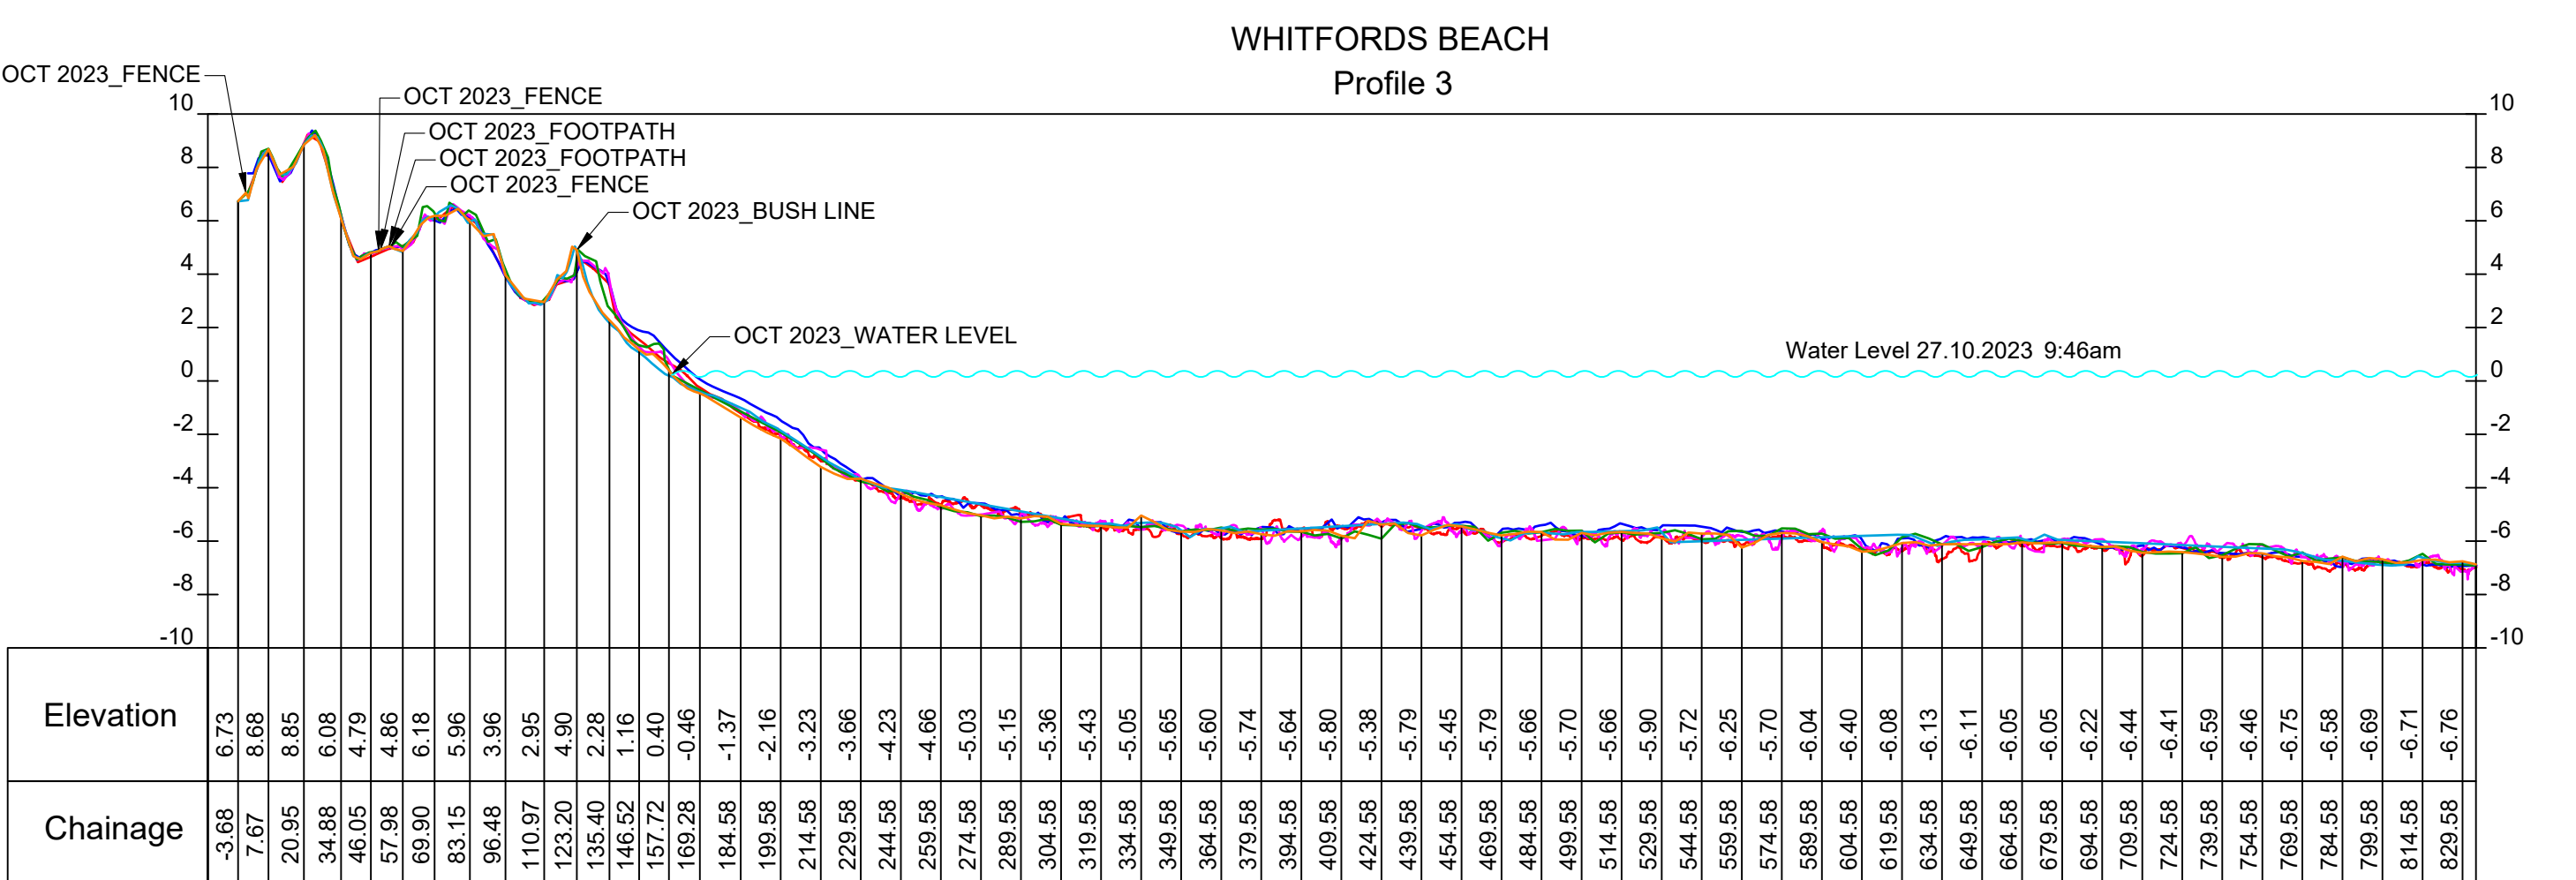

19139-PR03-2.0.dwg

VER.	DATE	BY	AMENDMENTS
1.0	31.10.2023	MDB	Issued for information
2.0	10.01.2024	MDB	Client amendments

Notes:

1. Heights established from SSM HAM77A via GPS connection.

2. Areas without profile data inaccessible due to coastal reef.

3. All historical profiles before October 2019 taken from client supplied drawings.

4. Profiles 8 - 10 removed due to construction of Ocean Reef Boat Harbour

5. For visual clarity only the last 6 recent profile lines shown

JBASURVEYS

44 Hardey Road, Belmont WA 6104
Ph: 9450 7188
email: admin@jbasurveys.com.au
web: www.jbasurveys.com.au

CLIENT:



m p rogers & associates pl

creating better coasts and ports


JOB NO: 19139	TITLE: PROFILE SURVEY			DATUM	N
PROJECT: CITY OF JOONDALUP COASTAL MONITORING PROFILES OCTOBER 2023				VERT: AHD	
				HORIZ: MGA94 Z50	
				SCALE: SEE PLAN	
DWG NO: 19139-PR03				VER: 2.0	
SURVEYOR: JMB	DATE OF SURVEY: 27.10.2023	DRAWN BY: MDB	APPROVED BY: NRW	SHEET NO: 1 OF 7	A1

Figure 5: Profile View of the Bridge Deck. The graph displays the elevation of the bridge deck structure and the water level. The x-axis represents Chainage (0+32 to 950+27), and the y-axis represents Elevation (0 to 12). The bridge deck is shown as a series of vertical lines. The water level is indicated by a red line, and the bush line is shown as a black line. The elevation starts at approximately 4.57 at Chainage 0+32 and rises to a peak of about 10.5 at Chainage 100+00, then gradually declines to about 8.5 at Chainage 950+27. The water level is shown as a cyan line that remains relatively constant at an elevation of about 0.5 throughout the profile.

Chainage	Elevation
0+32	4.57
13.61	2.58
24.82	2.88
39.78	7.37
53.11	9.71
66.69	8.81
77.87	6.18
90.67	5.80
104.99	2.39
116.34	1.81
133.13	0.83
145.73	0.65
160.27	-0.31
172.29	-0.49
185.27	-0.94
200.27	-1.46
215.27	-1.98
230.27	-2.51
245.27	-3.16
260.27	-3.87
275.27	-4.64
290.27	-5.30
305.27	-5.96
320.27	-6.53
335.27	-7.08
350.27	-7.67
365.27	-7.71
380.27	-8.05
395.27	-7.87
410.27	-7.91
425.27	-8.14
440.27	-8.04
455.27	-8.51
470.27	-8.78
485.27	-9.25
500.27	-9.08
515.27	-9.13
530.27	-9.44
545.27	-9.27
560.27	-9.42
575.27	-9.85
590.27	-9.60
605.27	-9.83
620.27	-9.74
635.27	-9.89
650.27	-9.63
665.27	-10.18
680.27	-9.90
695.27	-9.74
710.27	-9.39
725.27	-9.68
740.27	-9.69
755.27	-10.07
770.27	-10.27
785.27	-9.63
800.27	-9.66
815.27	-9.68
830.27	-9.56
845.27	-9.62
860.27	-9.66
875.27	-9.53
890.27	-9.32
905.27	-9.40
920.27	-9.35
935.27	-9.19
950.27	-8.84

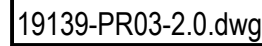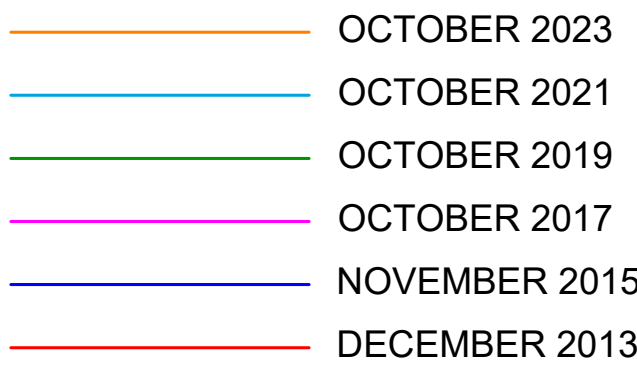
[illegible]



1. Heights established from SSM HAM77A via GPS connection.
2. Areas without profile data inaccessible due to coastal reef.
3. All historical profiles before October 2019 taken from client supplied drawings.
4. Profiles 8 - 10 removed due to construction of Ocean Reef Boat Harbour
5. For visual clarity only the last 6 recent profile lines shown

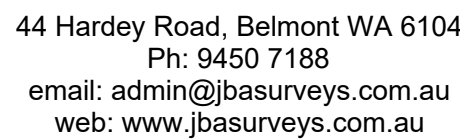


m p rogers & associates pl
creating better coasts and ports

JOB NO: 19139		TITLE: PROFILE SURVEY		DATUM		
PROJECT: CITY OF JOONDALUP COASTAL MONITORING PROFILES OCTOBER 2023				VERT: AHD		
				HORIZ: MGA94 Z50		
				SCALE: SEE PLAN		
				DWG NO: 19139-PR03		VER: 2.0
				SHEET NO: 2 OF 7		A1
SURVEYOR: JMB	DATE OF SURVEY: 27.10.2023	DRAWN BY: MDB	APPROVED BY: NRW			


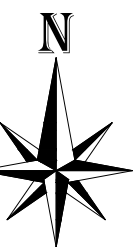



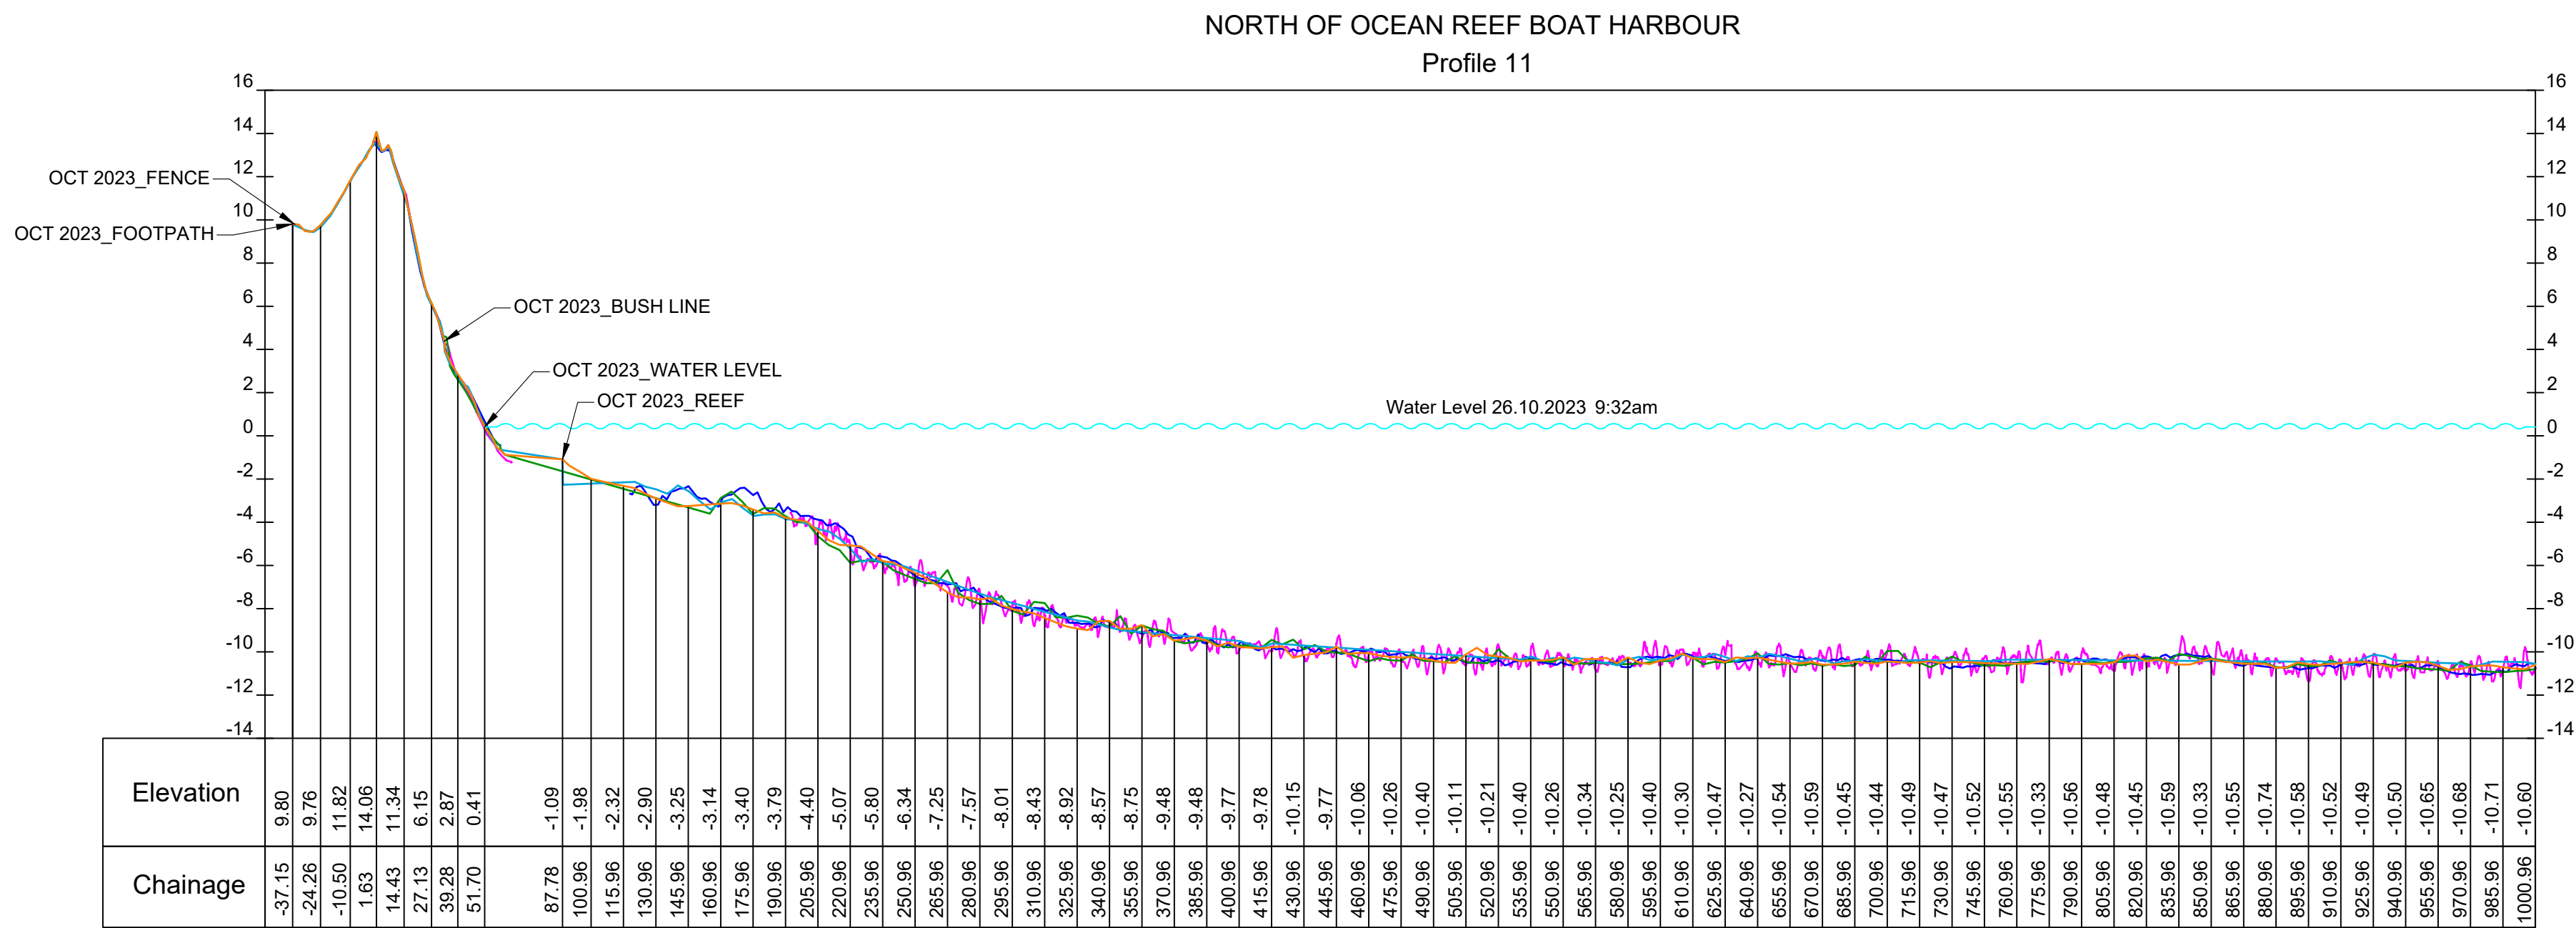
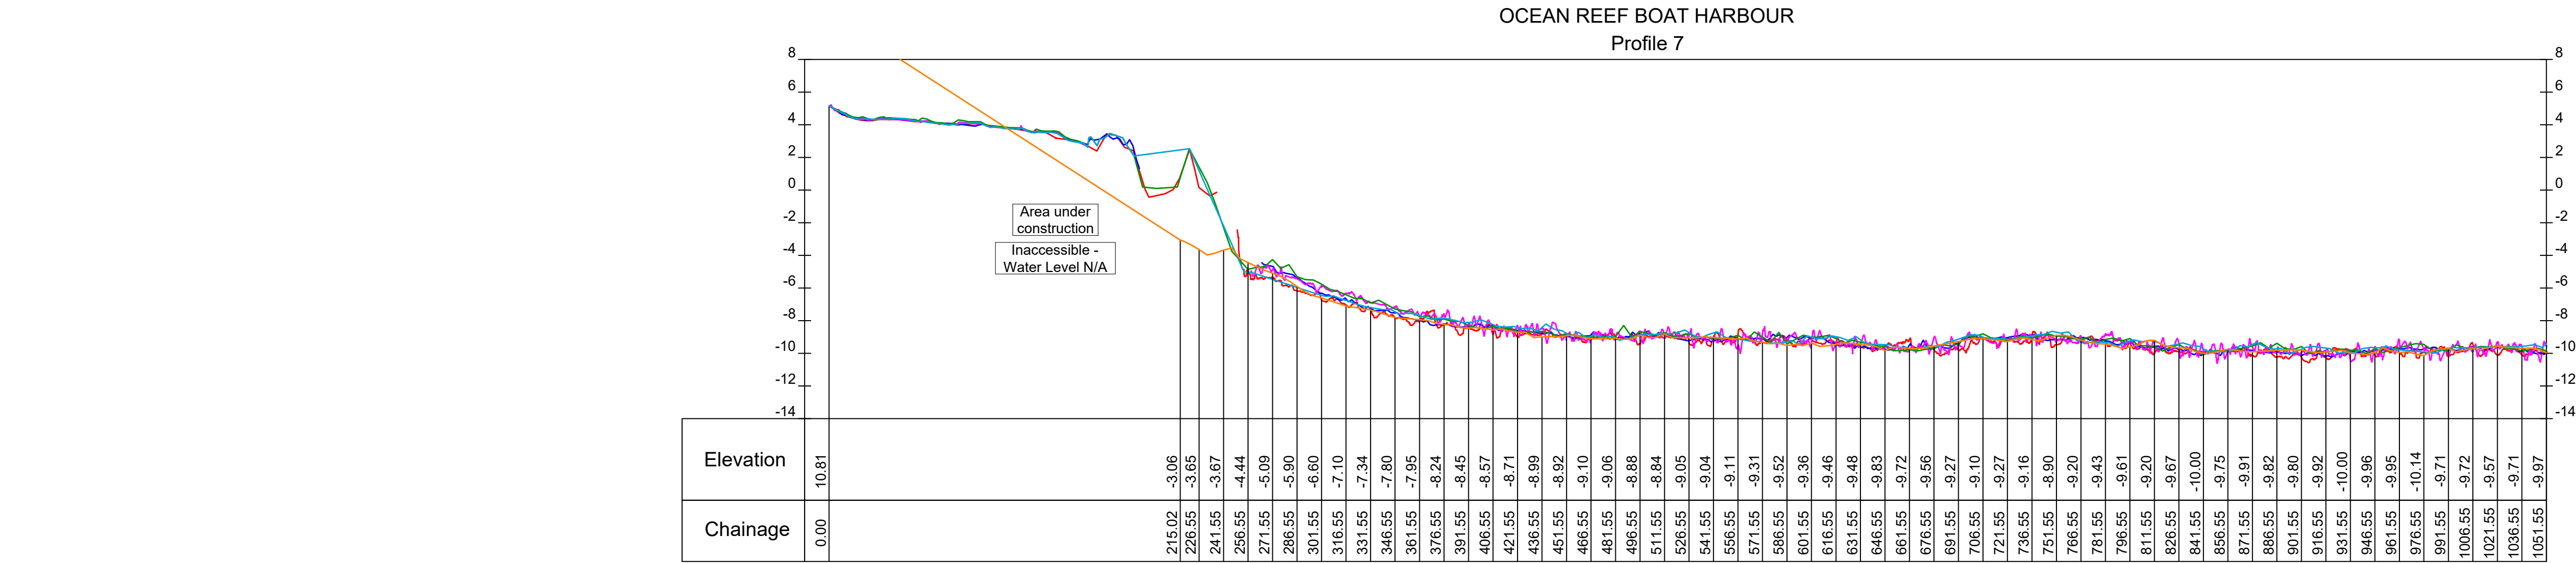


- OCTOBER 2023
- OCTOBER 2021
- OCTOBER 2019
- OCTOBER 2017
- NOVEMBER 2015
- DECEMBER 2013

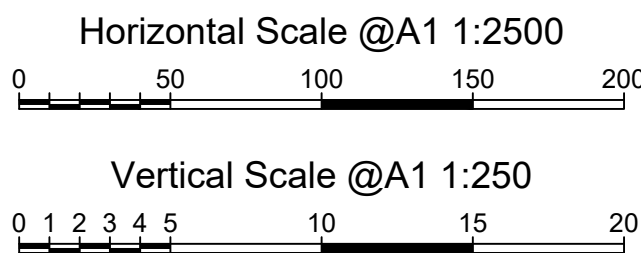

19139-PR03-2.0.dwg				Notes: 1. Heights established from SSM HAM77A via GPS connection. 2. Areas without profile data inaccessible due to coastal reef. 3. All historical profiles before October 2019 taken from client supplied drawings. 4. Profiles 8 - 10 removed due to construction of Ocean Reef Boat Harbour 5. For visual clarity only the last 6 recent profile lines shown		JBASURVEYS 44 Hardey Road, Belmont WA 6104 Ph: 9450 7188 email: admin@jbasurveys.com.au web: www.jbasurveys.com.au m p rogers & associates pl creating better coasts and ports		CLIENT:		JOB NO: 19139		TITLE: PROFILE SURVEY		DATUM		N	
PROJECT:		CITY OF JOONDALUP COASTAL MONITORING PROFILES OCTOBER 2023								VERT: AHD HORIZ: MGA94 Z50							
										SCALE: SEE PLAN							
										DWG NO: 19139-PR03							
SURVEYOR: JMB		DATE OF SURVEY: 27.10.2023								DRAWN BY: MDB		APPROVED BY: NRW		SHEET NO: 3 OF 7		VER: 2.0	

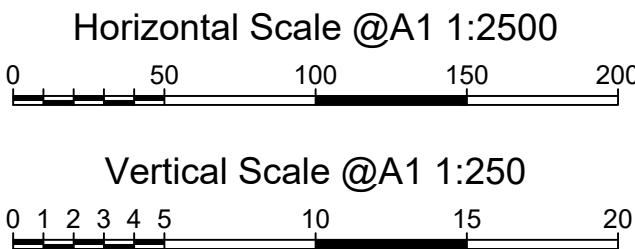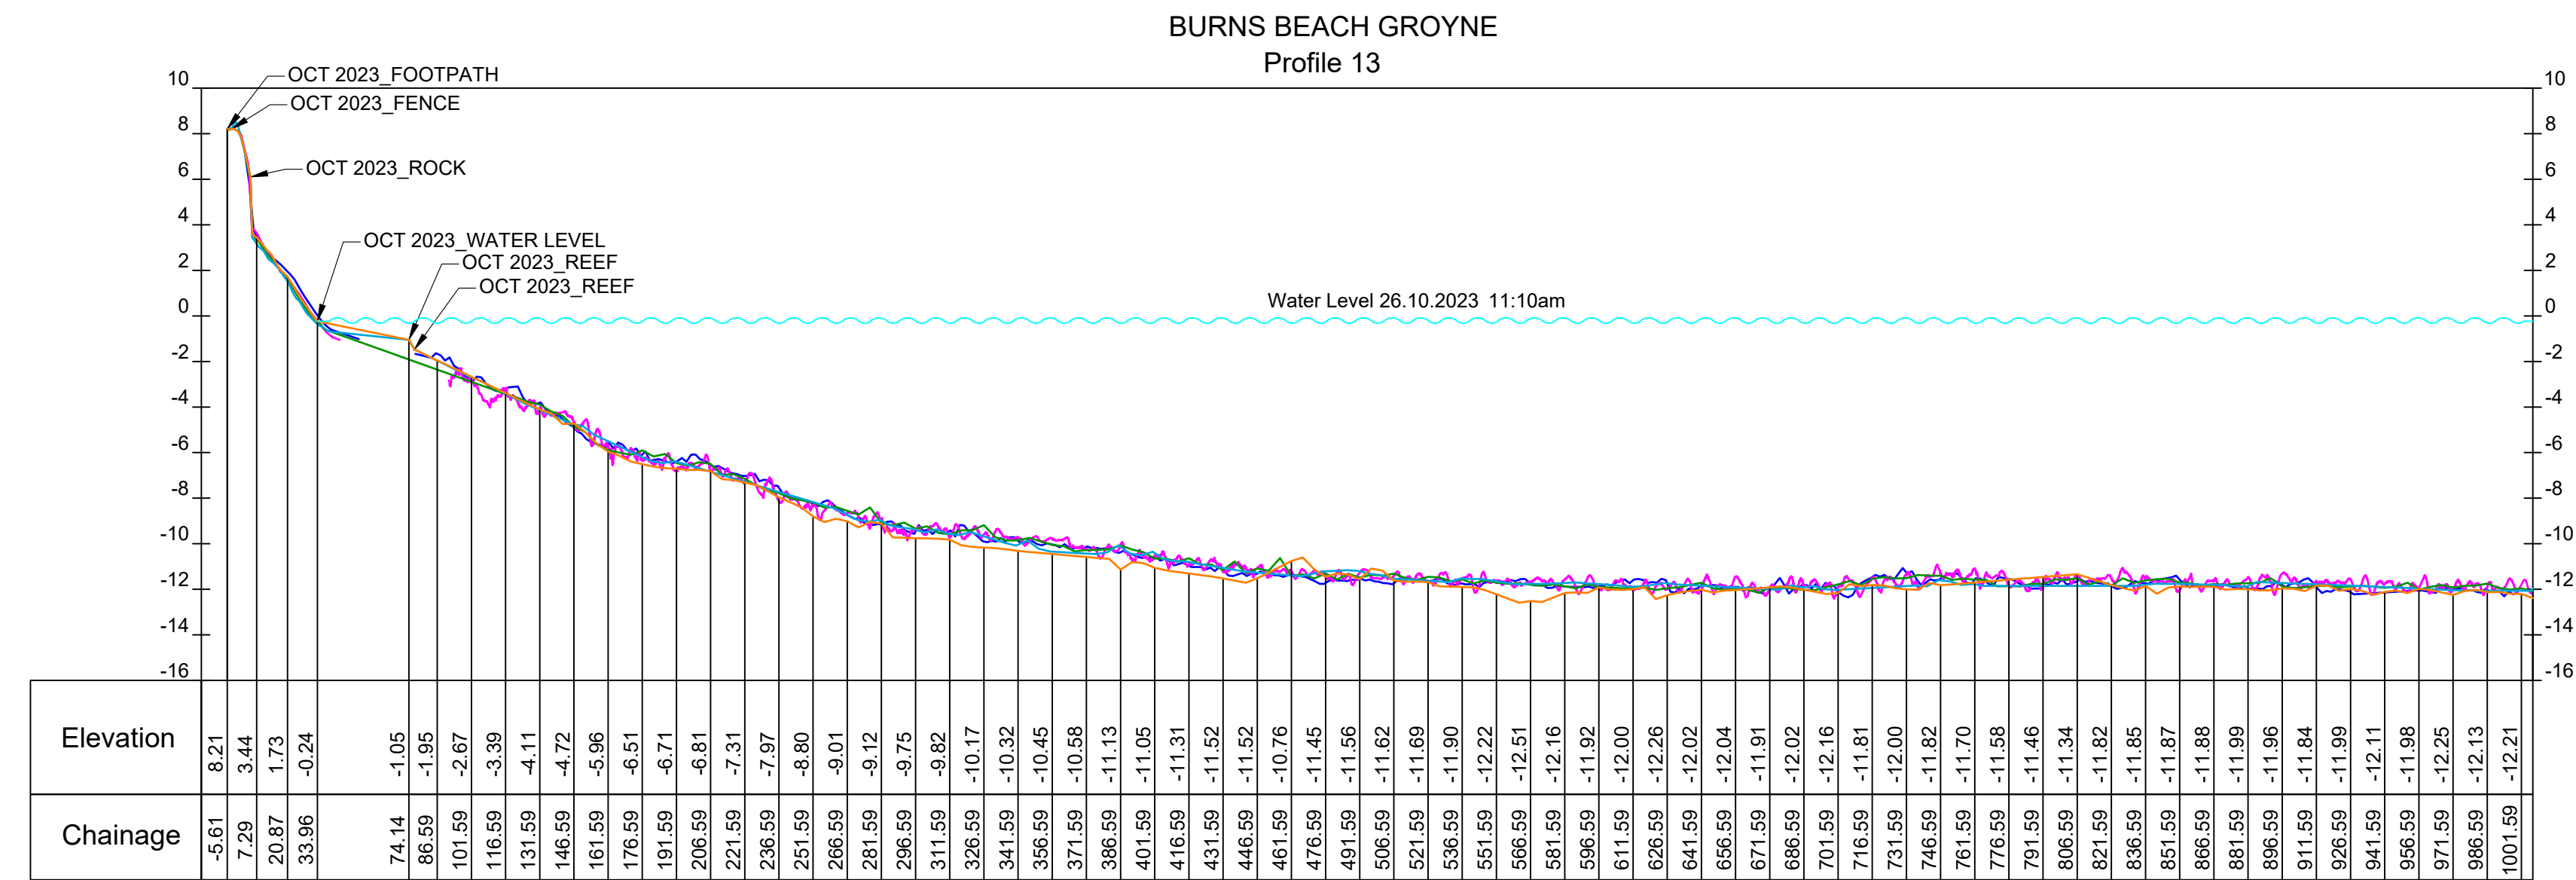

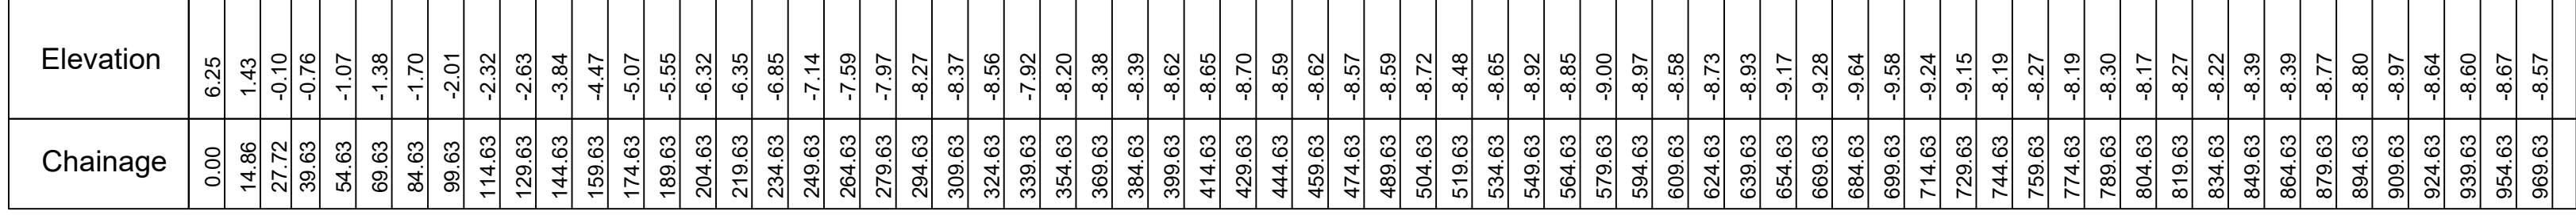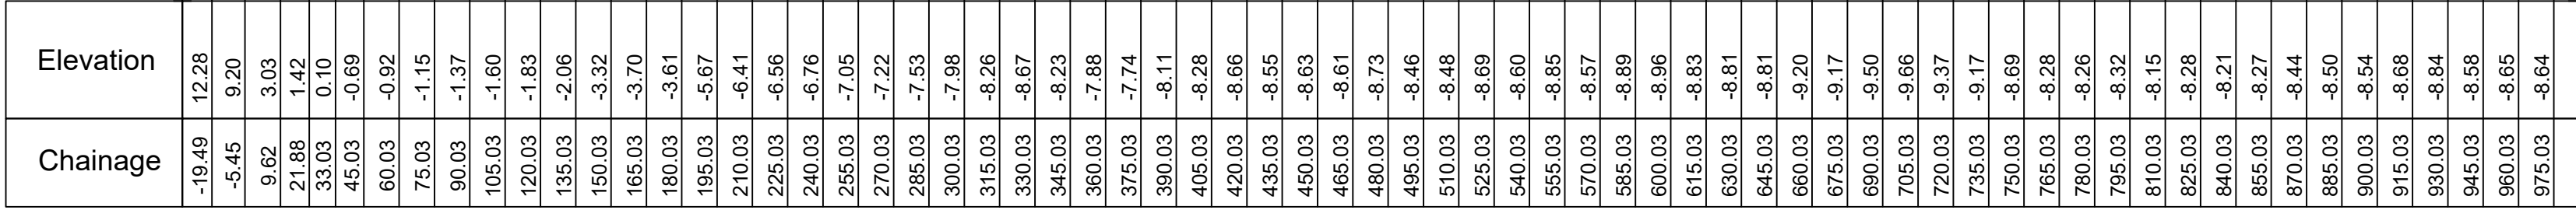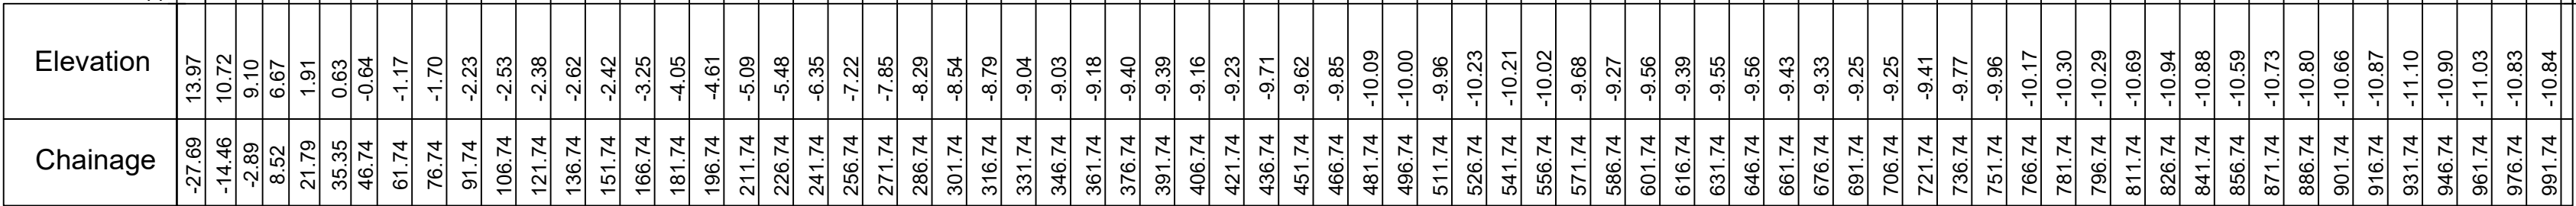

A vertical timeline on the left side of the slide, consisting of a series of horizontal lines of different colors (orange, blue, green, magenta, blue, red) connected by a vertical line. Each line corresponds to a date on the right.

- OCTOBER 2023
- OCTOBER 2021
- OCTOBER 2019
- OCTOBER 2017
- NOVEMBER 2015
- DECEMBER 2013

Horizontal Scale @A1 1:2500

0 50 100 150 200

Vertical Scale @A1 1:250

0 1 2 3 4 5 10 15 20

[illegible]

Notes:

1. Heights established from SSM HAM77A via GPS connection.
2. Areas without profile data inaccessible due to coastal reef.
3. All historical profiles before October 2019 taken from client supplied drawings.
4. Profiles 8 - 10 removed due to construction of Ocean Reef Boat Harbour
5. For visual clarity only the last 6 recent profile lines shown






44 Hardey Road, Belmont WA 6104
Ph: 9450 7188
email: admin@jbasurveys.com.au
web: www.jbasurveys.com.au


CLIENT:



JOB NO: 19139		TITLE: PROFILE SURVEY		DATUM		
PROJECT: CITY OF JOONDALUP COASTAL MONITORING PROFILES OCTOBER 2023				VERT: AHD		
				HORIZ: MGA94 Z50		
				SCALE: SEE PLAN		
				DWG NO: 19139-PR03		VER: 2.0
				SHEET NO: 6 OF 7		A1
SURVEYOR: JMB	DATE OF SURVEY: 27.10.2023	DRAWN BY: MDB	APPROVED BY: NRW			

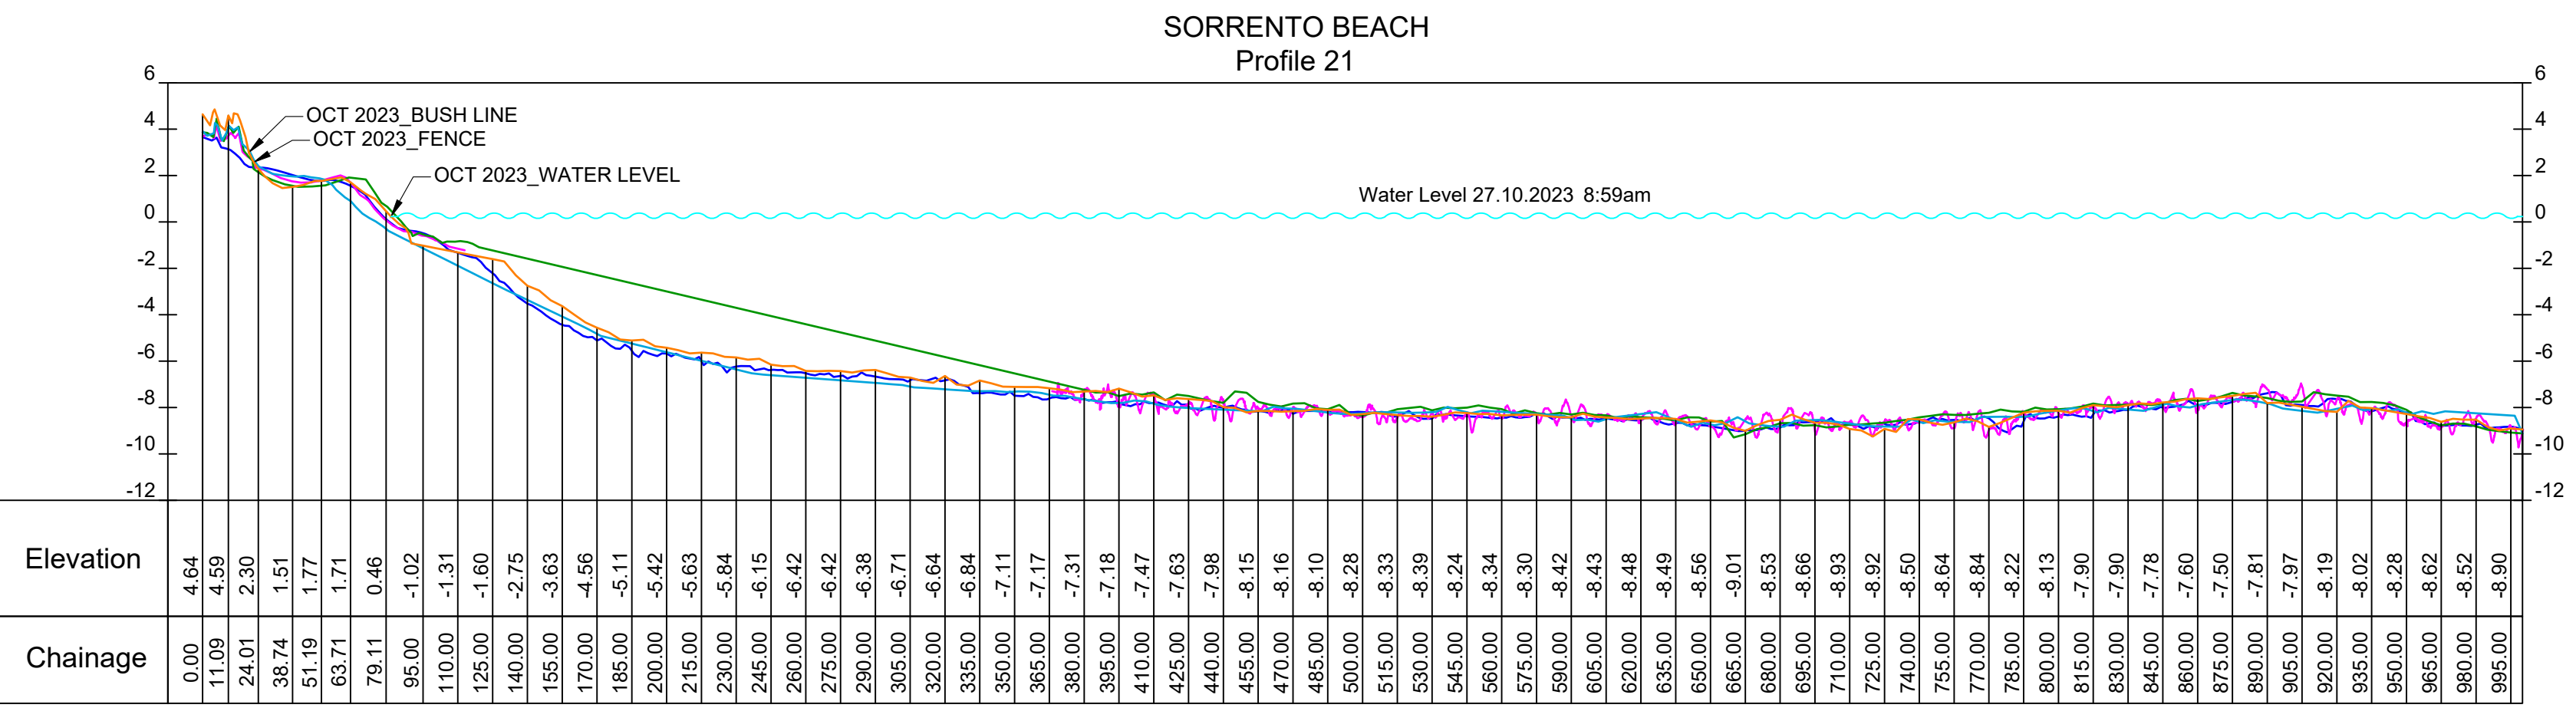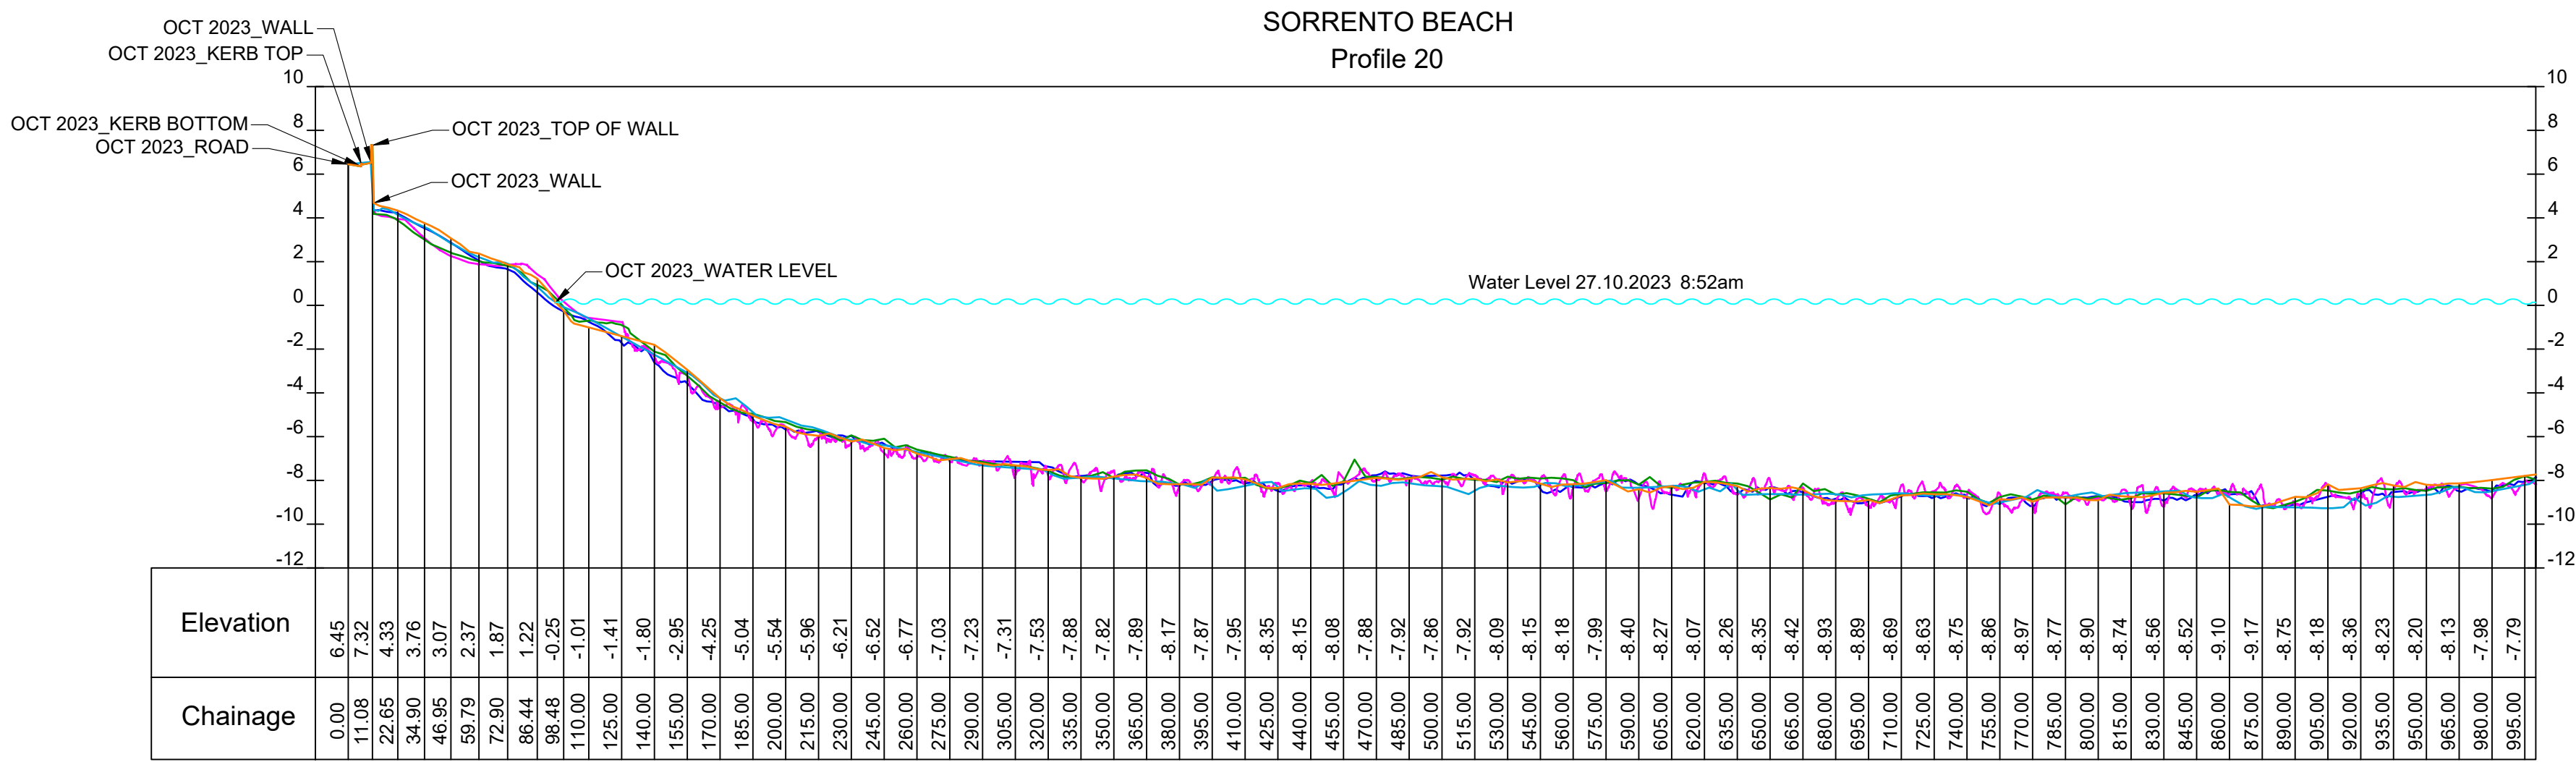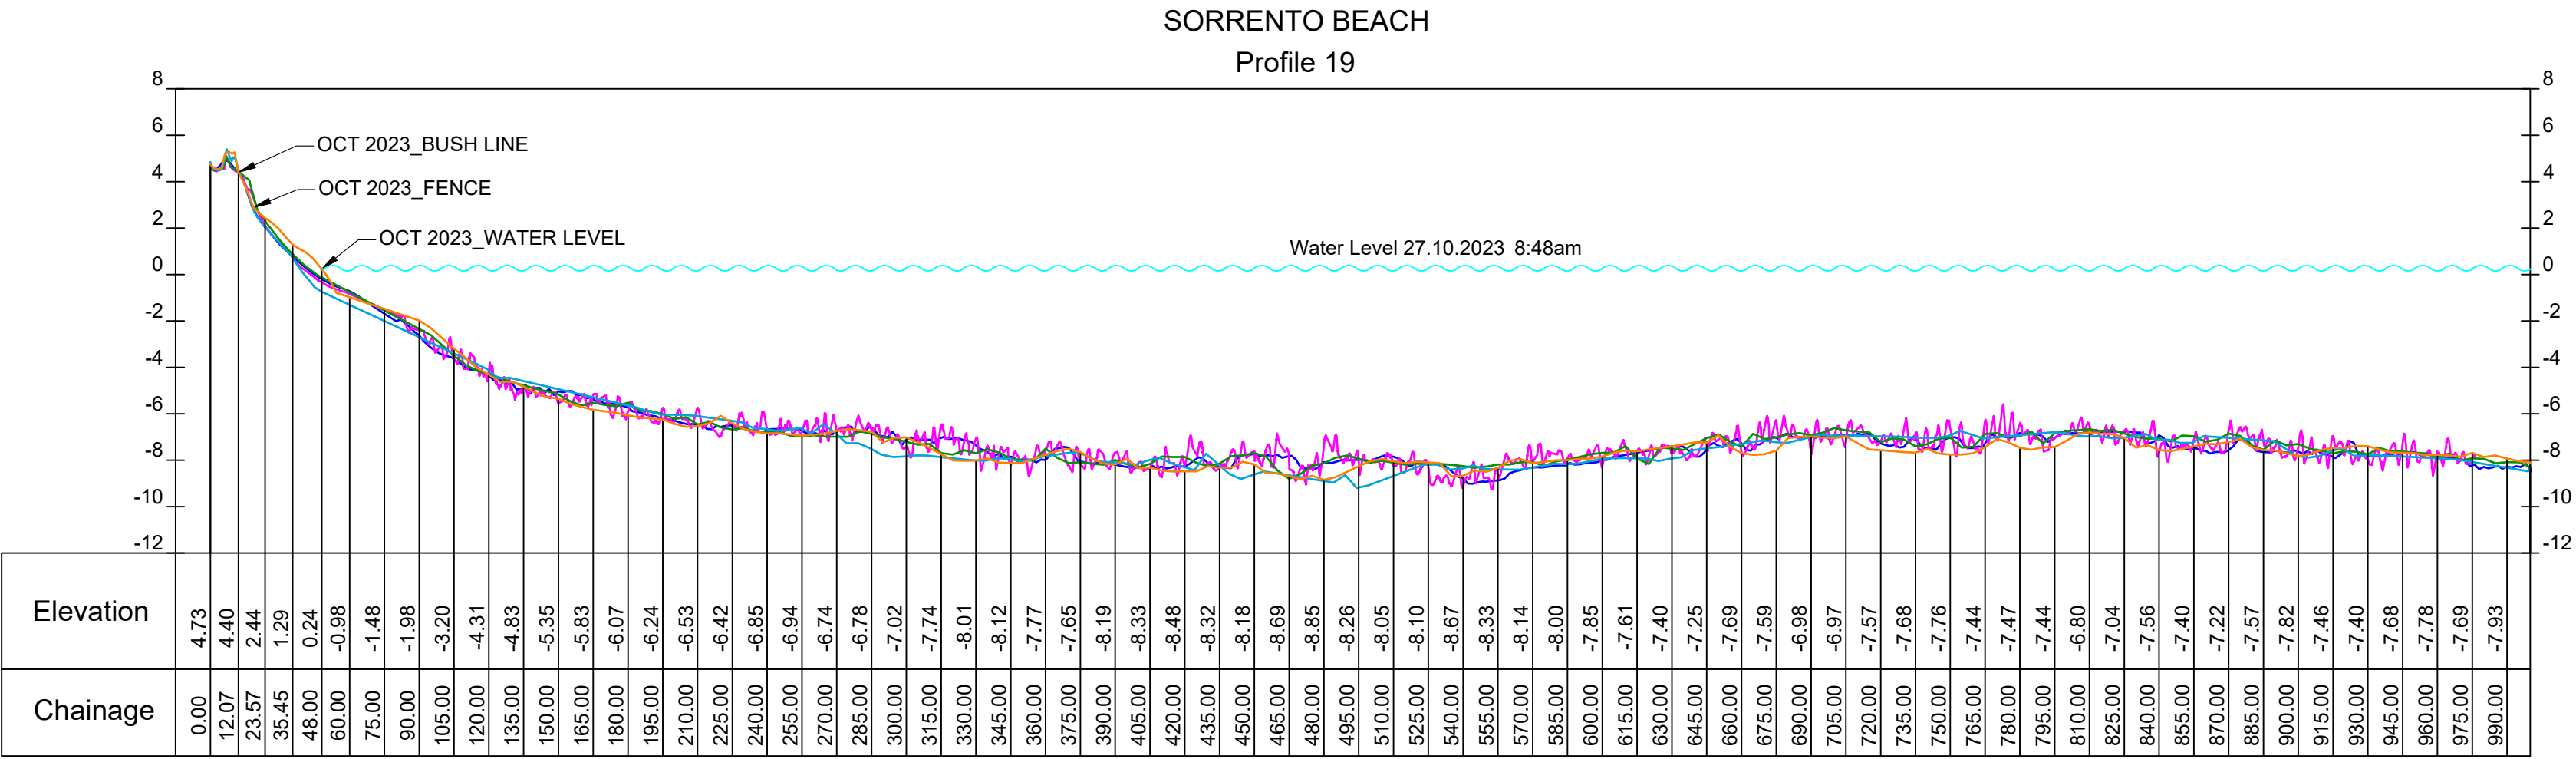

- OCTOBER 2023
- OCTOBER 2021
- OCTOBER 2019
- OCTOBER 2017
- NOVEMBER 2015
- DECEMBER 2013

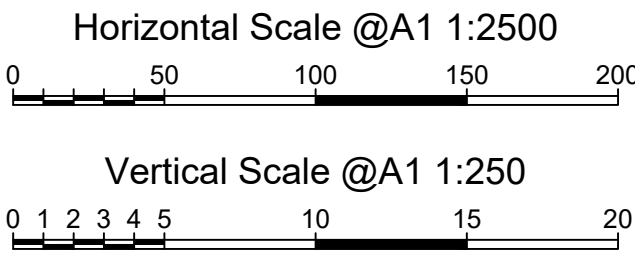

19139-PR03-2.0.dwg

VER.	DATE	BY	AMENDMENTS
1.0	31.10.2023	MDB	Issued for Information
2.0	10.01.2024	MDB	Client amendments

- Notes:
- Heights established from SSM HAM77A via GPS connection.
 - Areas without profile data inaccessible due to coastal reef.
 - All historical profiles before October 2019 taken from client supplied drawings.
 - Profiles 8 - 10 removed due to construction of Ocean Reef Boat Harbour
 - For visual clarity only the last 6 recent profile lines shown



44 Hardey Road, Belmont WA 6104
Ph: 9450 7188
email: admin@jbasurveys.com.au
web: www.jbasurveys.com.au

CLIENT:

m p rogers & associates pl
creating better coasts and ports

JOB NO: 19139	TITLE: PROFILE SURVEY	DATUM	N
PROJECT:	CITY OF JOONDALUP COASTAL MONITORING PROFILES OCTOBER 2023	VERT: AHD HORIZ: MGA94 Z50 SCALE: SEE PLAN	
SURVEYOR: JMB	DATE OF SURVEY: 27.10.2023	DRAWN BY: MDB	APPROVED BY: NRW
SHEET NO: 7 OF 7			VER: 2.0 A1