



UPPER FLOOR PLAN
SCALE 1:100

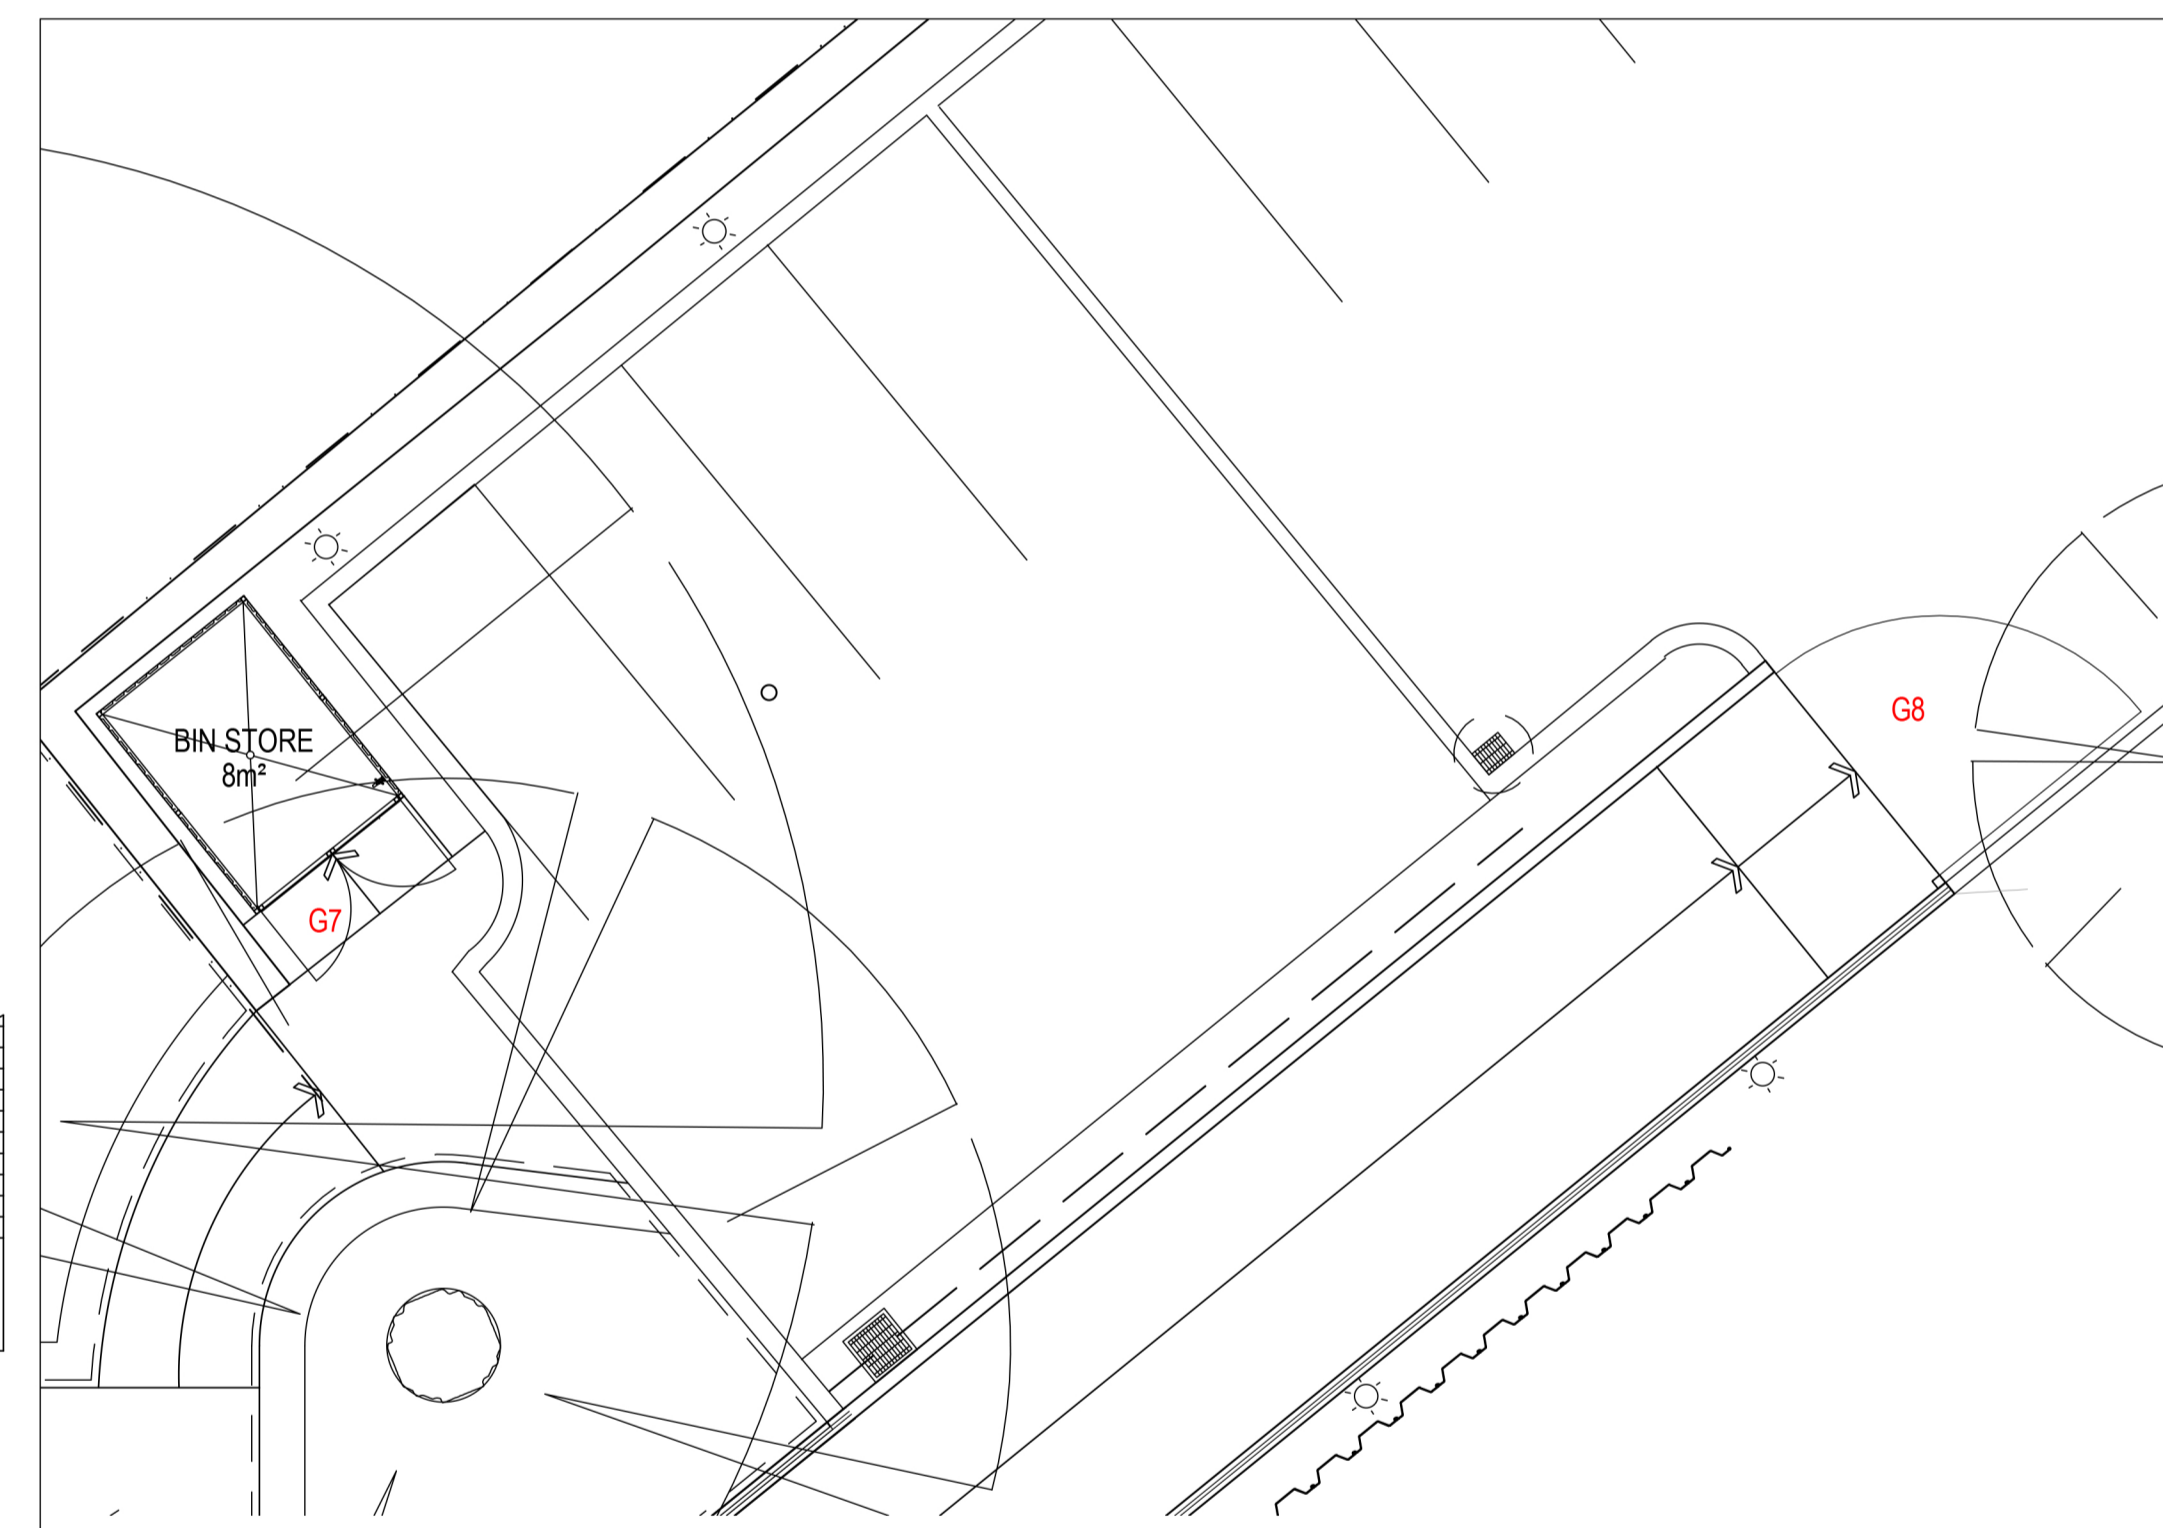

CAR PARK PLAN
SCALE 1:100

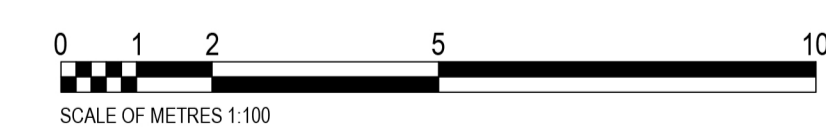

REV	DATE:	REMARKS:	REV	DATE:	REMARKS:
A	05/05/21	ISSUED FOR CLIENT	E	01/03/23	AS CONSTRUCTED
B	13/05/21	ISSUED FOR CLIENT	F		
C	06/07/21	ISSUED FOR CLIENT, ADDED G7 & G8	G		
D	15/07/21	ISSUED FOR CLIENT	H		

DRAWING TITLE:
**UPPER FLOOR/ CARPARK
DOOR SCHEDULE PLAN**

PROJECT:
**CHICHESTER PARK COMMUNITY SPORTING
FACILITY**

City of Joondalup
Asset Management

PO Box 21, Joondalup
Western Australia, 6919
Telephone: (08) 9400 4000
Facsimile: (08) 9300 1383



DATE:
MAR. 21

SCALE:
1.100 @ A1

DRAWN:
A.S

CHKD/APRVD:

BUILDING No:
B2016

BUILDING NAME:
**CHICHESTER PARK
COMMUNITY FACILITY**

DRAWING No:
A2.02a

REV No:
E

THIS DRAWING IS THE PROPERTY OF "THE CITY OF JOONDALUP ASSET MANAGEMENT" AND MAY NOT BE COPIED OR USED WITHOUT CONSENT.
CHECK ALL DIMENSIONS BEFORE FABRICATION, AGAINST ON SITE DIMENSIONS.

THIS DRAWING TO BE PLOTTED ON A1 SIZE PAPER - DO NOT SCALE. IF IN DOUBT ENQUIRE WITH ASSET MGT 94004340